


Model DU080C3


EXAMPLE VALUES OF "D"

10F/8422-03 78MM


OMP-600 56MM

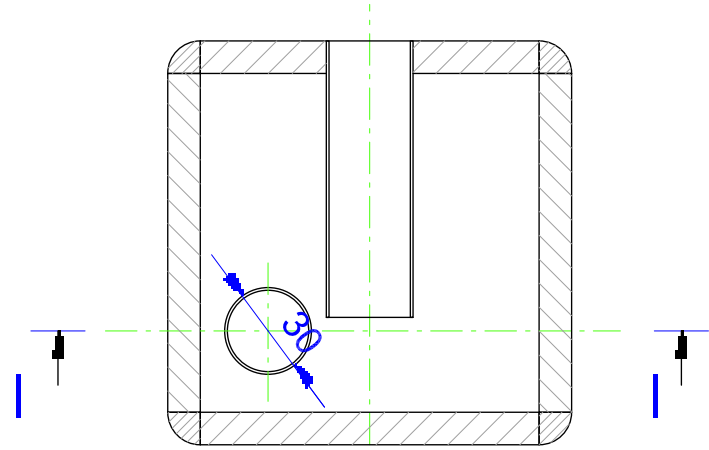


Section AA

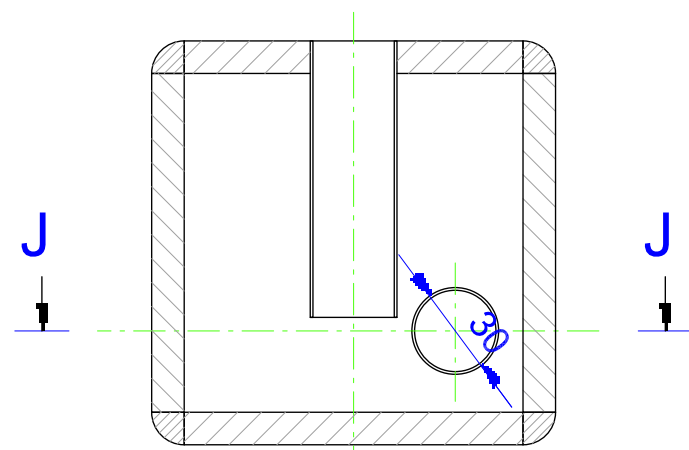


Section BB

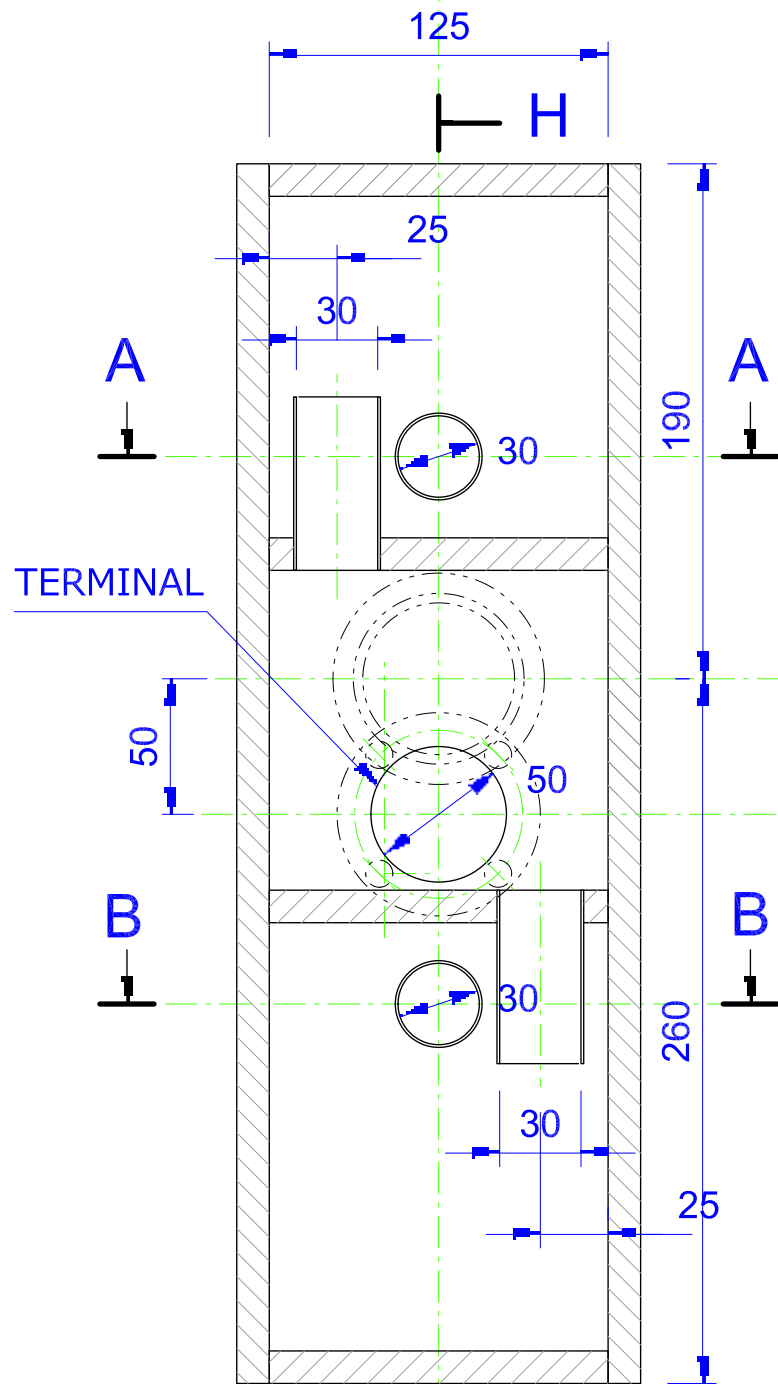

Section II

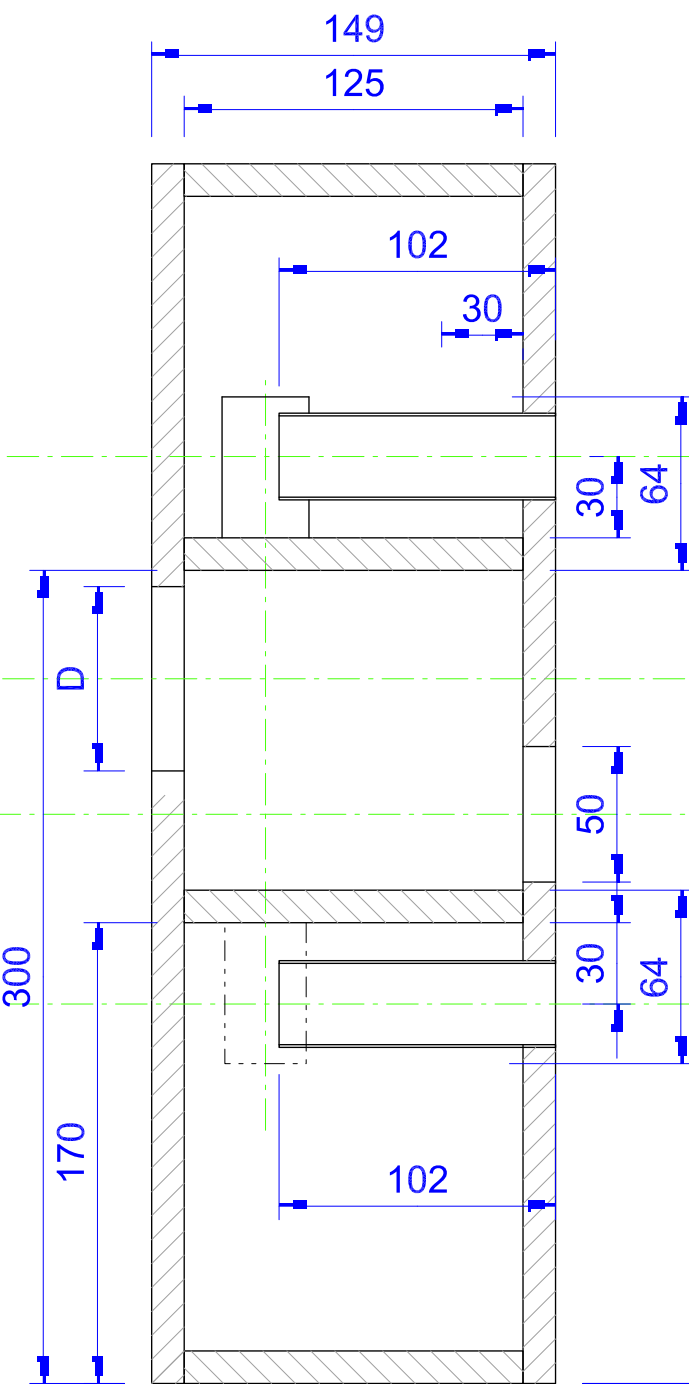

Section CH

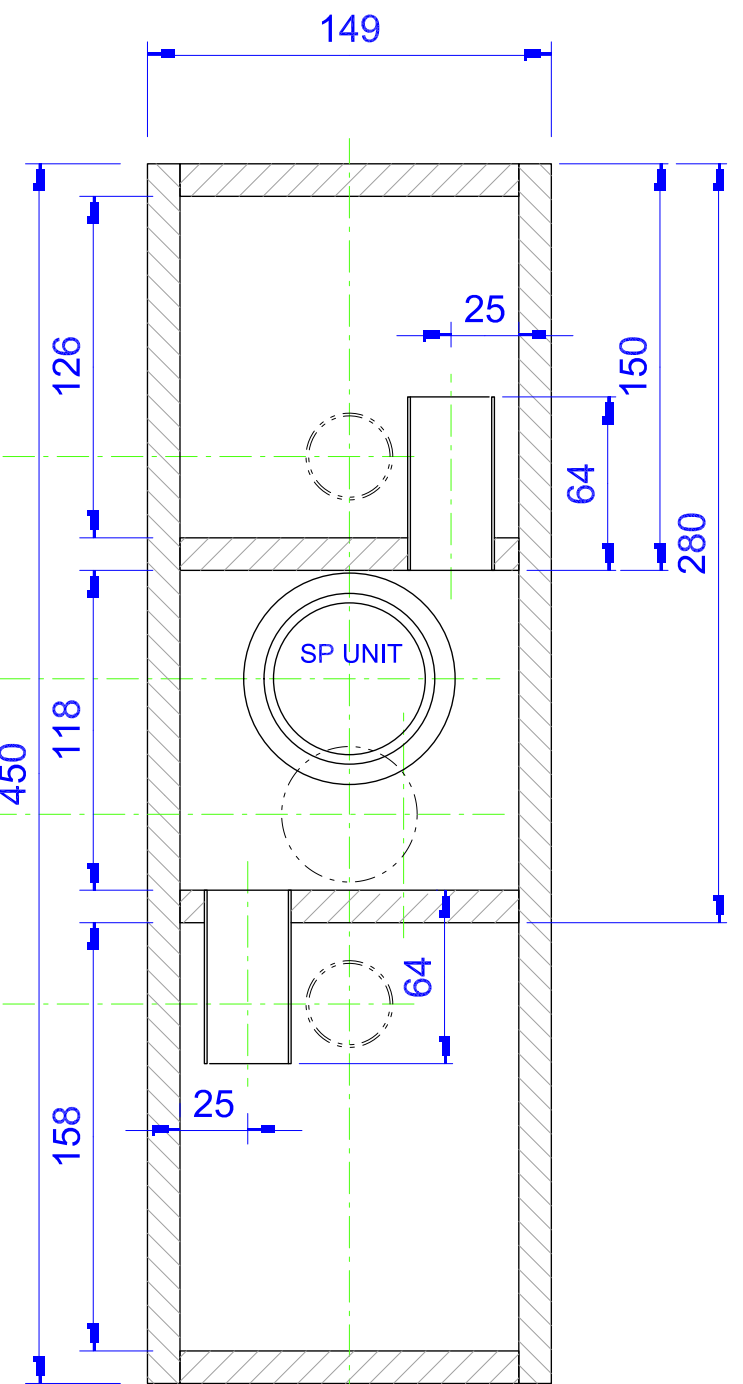

Section JJ